

A1.6

A1.41





NOTES

ALL DIMENSIONS IN MM
LIGHTING BARS S.W.L = 30KG/M
CURTAIN TRACK S.W.L = 17.5KG/M


THE FOLLOWING SERVICES ARE FOR INDICATIVE PURPOSES ONLY:

TSL CONTAINMENT
DUCTWORK

THESE SERVICES ARE DRAWN AS RECEIVED FROM DESIGNERS DURING THE APPROVAL PROCESS AND MAY NOT REFLECT WHAT HAS BEEN INSTALLED.

-  CURTAIN TRACK & FIXING
-  P1001 UNISTRUT OR EQUIVALENT
-  48MM LIGHTING BAR
-  M10 STUD DROP FROM CEILING

TO BE READ IN CONJUNCTION WITH ELEVATIONS
DWG LSI 2550 02 01 02

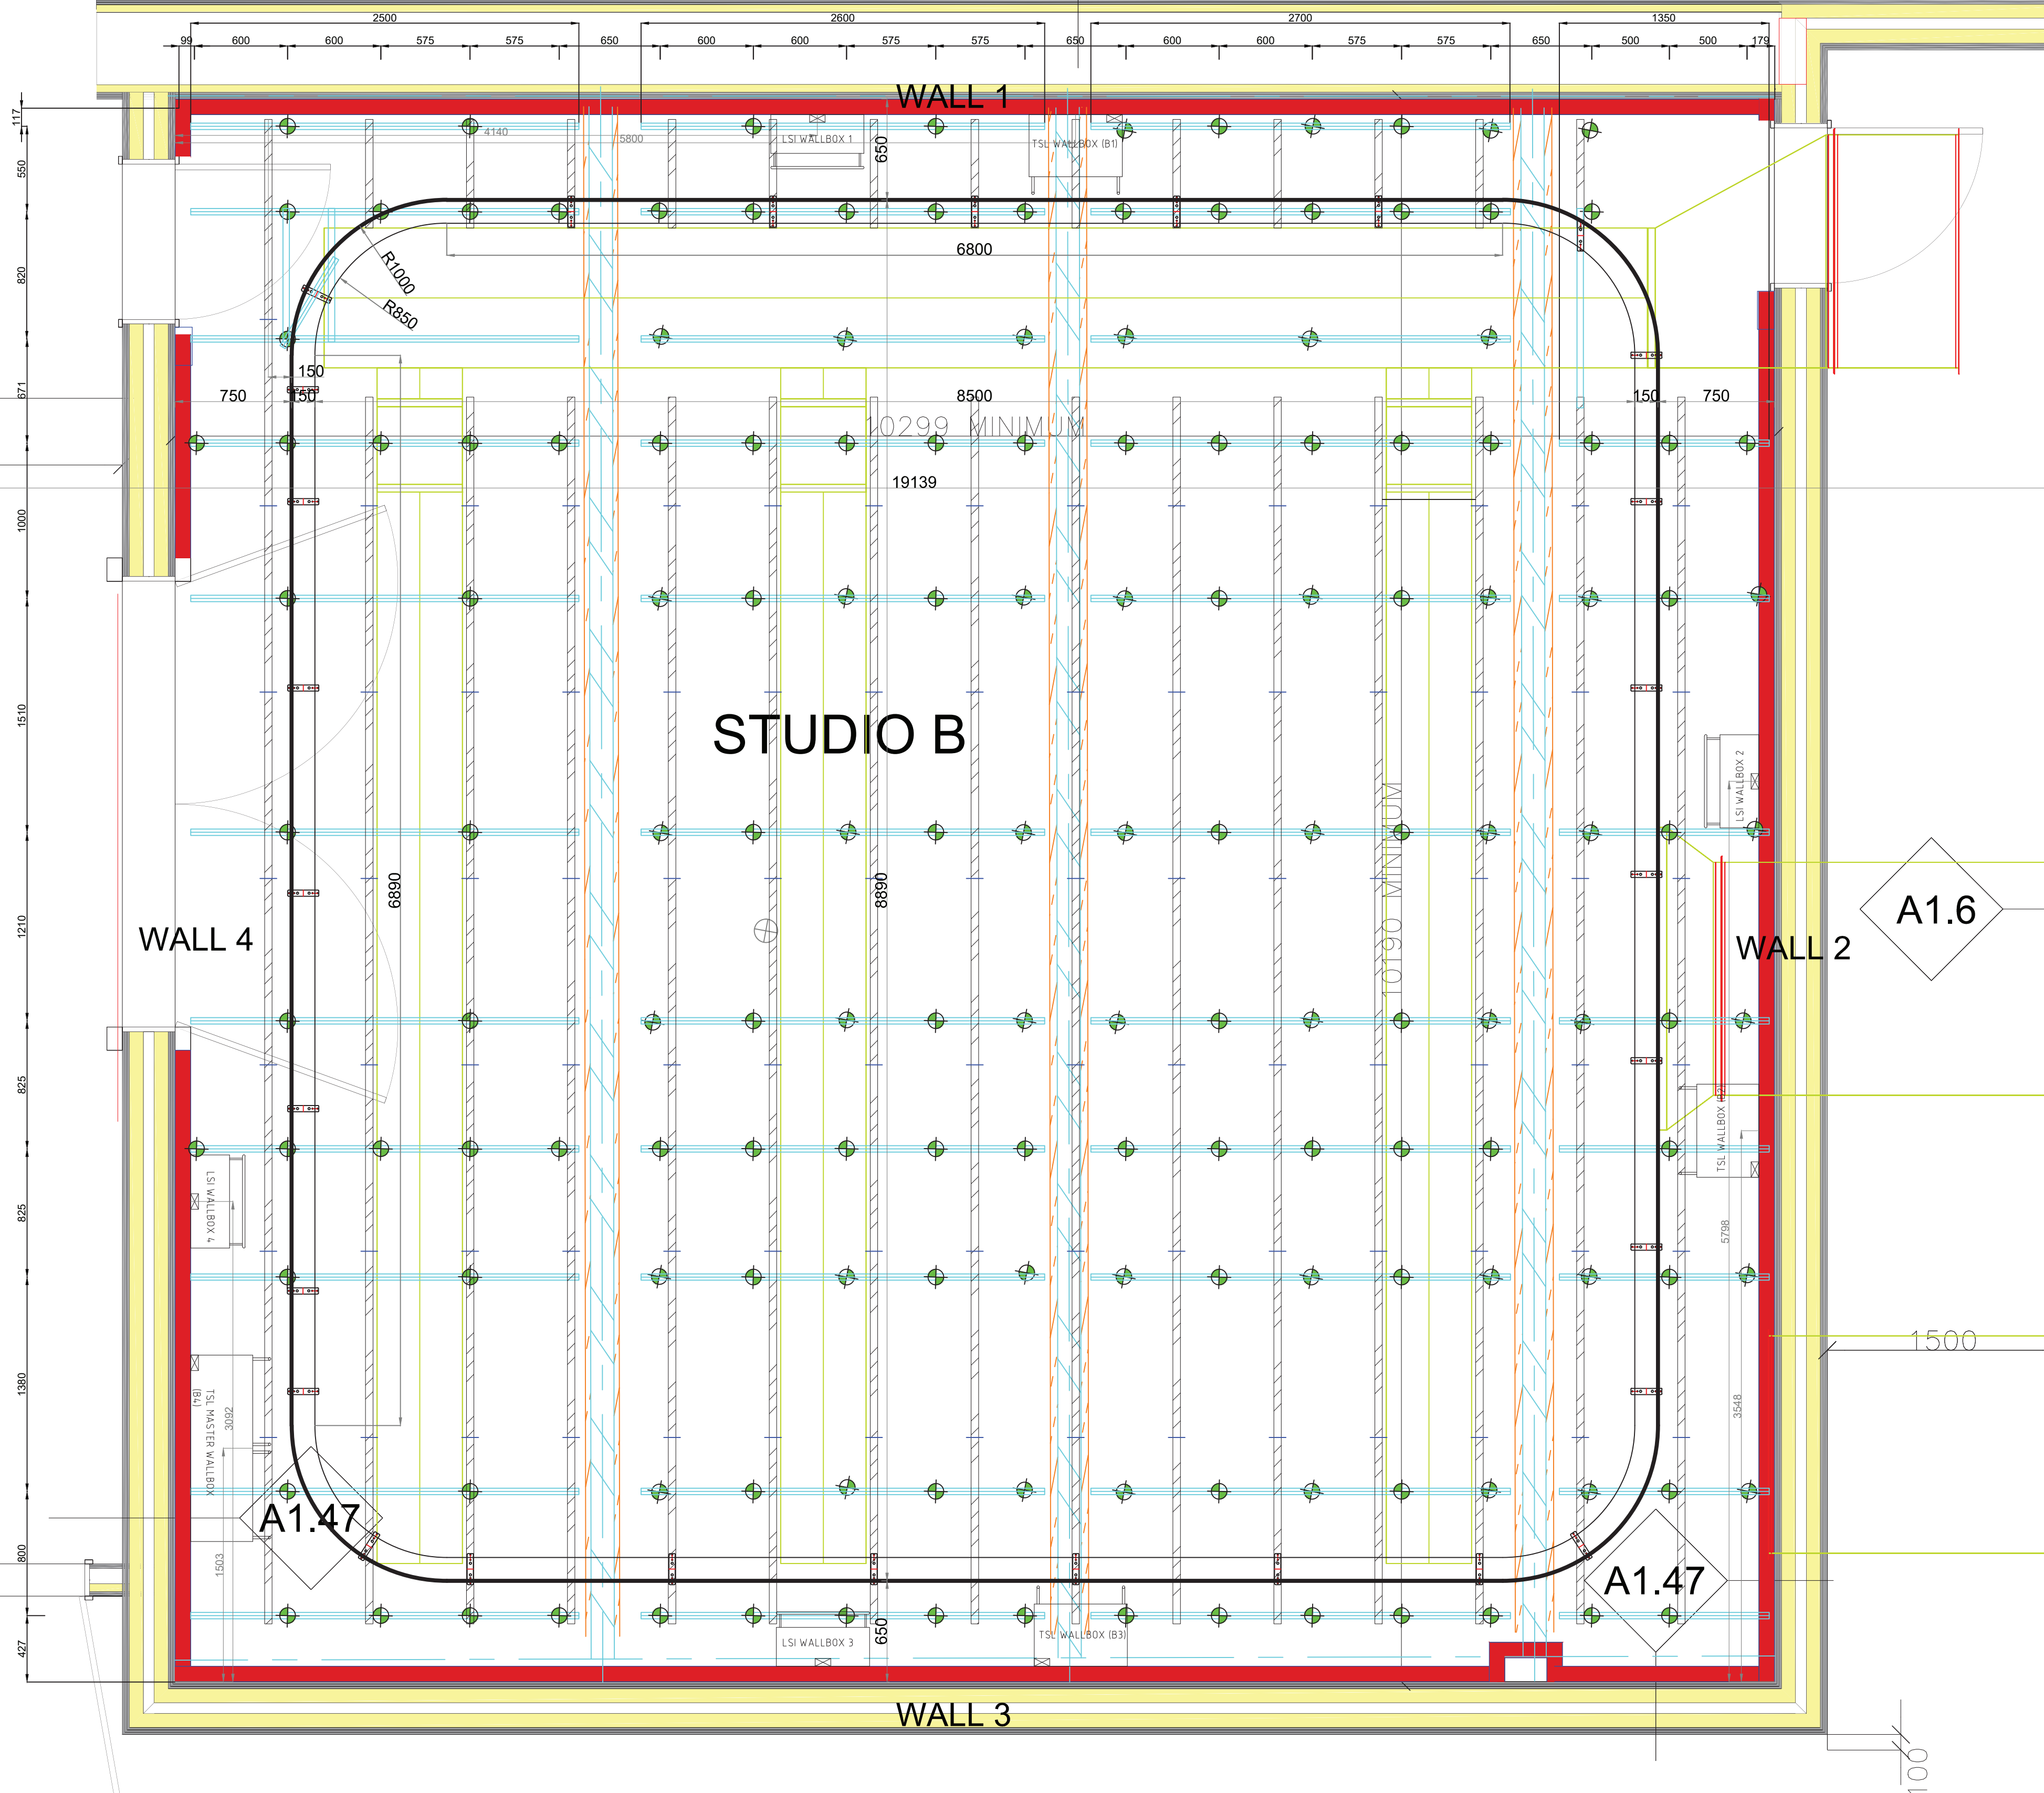

IMG STUDIOS

5 Longwalk Road,
Stockley Park,
UB11 1FE
United Kingdom
Tel: +44 (0)20 3314 5555
Web: www.img-studios.com



IMG TELEVISION STUDIO RELOCATION

STOCKLEY PARK

DATE

27th APRIL 2013

9/7/13

-

-

-

-

DESCRIPTION

ADDED DIMS

REVISED WITH AS BUILT INFORMATION

-

-

-

-

REV

A

B

PROJECT No.

2550

FILE NAME

2550 02

DESIGNED BY

RM

DRAWN BY

RM

APPROVED BY

DRAWING TITLE

STUDIO B
PRIMARY GRID LAYOUT
SHOWING SUSPENSION
POINTS FROM SOFFIT

DRAWING No. 2550 02 01 01

DATE 18th APRIL 2013

SCALE

1:25 @ A1

REVISION

B

ISSUE AS BUILT