NO REPRODUCTION OR UNAUTHORISED USE IN PART OR WHOLE SHALL BE MADE OF THE INFORMATION CONTAINED HERIN WITHOUT PRIOR WRITTEN CONSENT.

DO NOT SCALE - IF IN DOUBT ASK

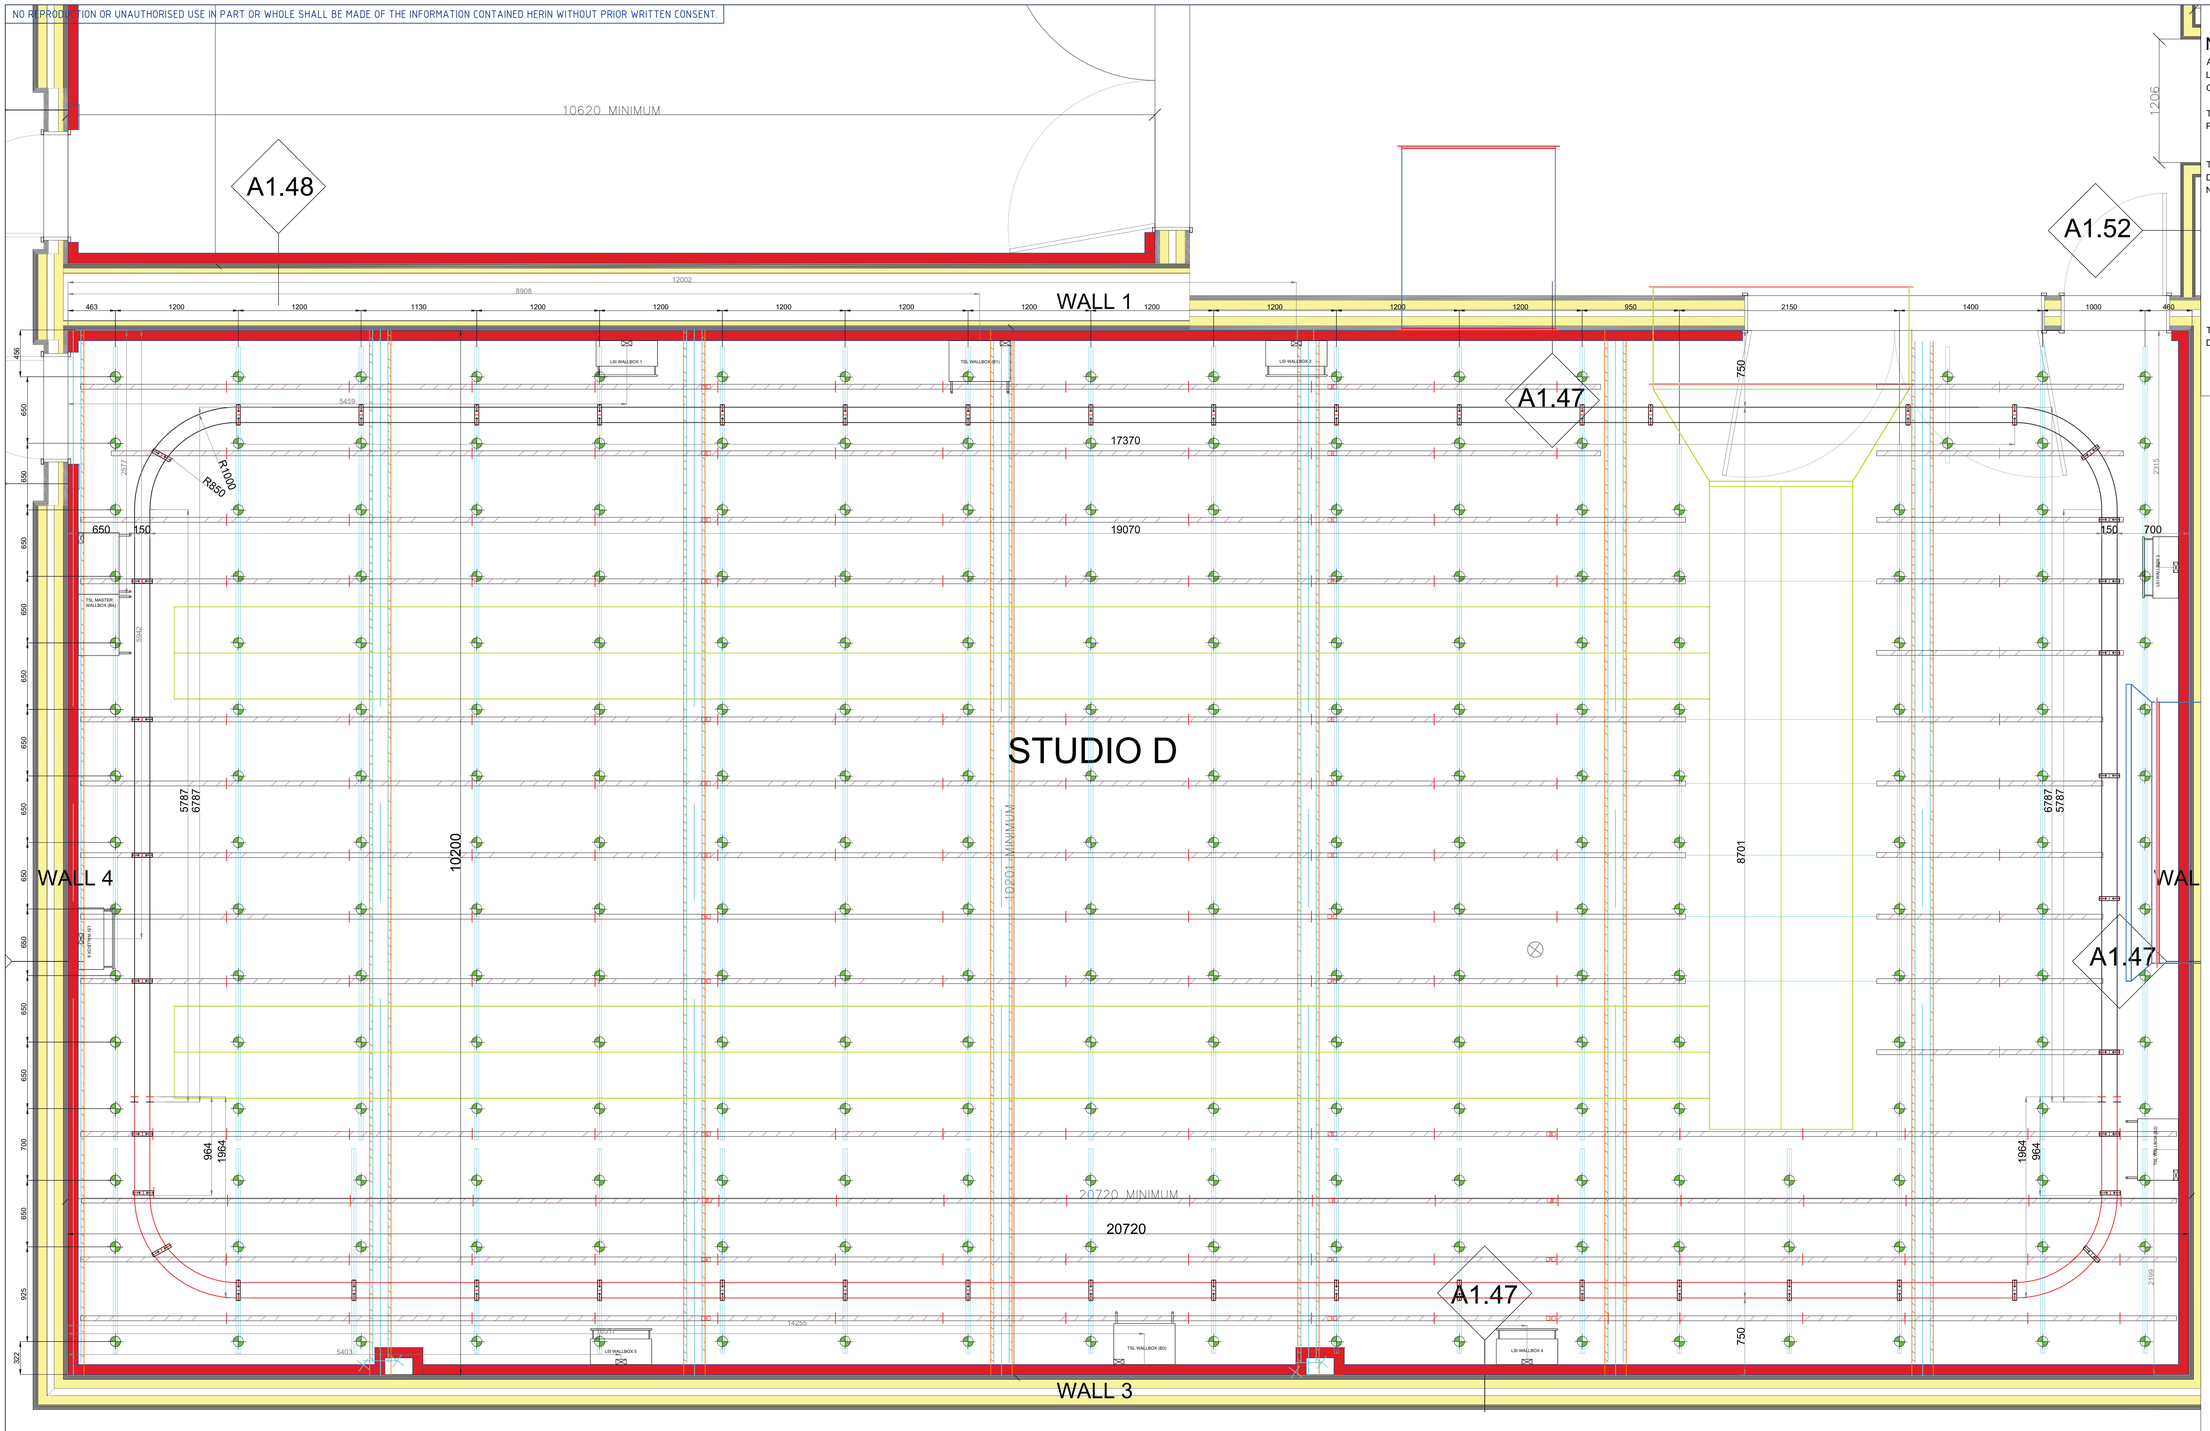

NOTES

ALL DIMENSIONS IN MM
LIGHTING BARS S.W.L = 30KG/M
CURTAIN TRACK S.W.L = 17.5KG/M

THE FOLLOWING SERVICES ARE FOR INDICATIVE PURPOSES ONLY:
TSL CONTAINMENT
DUCTWORK
THESE SERVICES ARE DRAWN AS RECEIVED FROM DESIGNERS DURING THE APPROVAL PROCESS AND MAY NOT REFLECT WHAT HAS BEEN INSTALLED.

CURTAIN TRACK & FIXING
P1001 UNISTRUT OR EQUIVALENT
48MM LIGHTING BAR
M10 STUD DROP FROM CEILING

TO BE READ IN CONJUNCTION WITH ELEVATIONS DWG LSI 2550 04 01 02

IMG STUDIOS

5 Longwalk Road,
Stockley Park,
UB11 1FE
United Kingdom
Tel: +44 (0)20 3314 5555
Web: www.img-studios.com

IMG TELEVISION STUDIO RELOCATION

STOCKLEY PARK

DATE	DESCRIPTION	REV
-		
-		
-		

PROJECT No. 2550
FILE NAME 2550 04
DESIGNED BY RM
DRAWN BY RM
APPROVED BY

DRAWING TITLE
STUDIO D
PRIMARY GRID LAYOUT
SHOWING SUSPENSION
POINTS FROM SOFFIT

DRAWING No. 2550 04 01 01
REVISION C
DATE 22nd APRIL 2013
SCALE 1:30 @ A1
ISSUE AS BUILT